NEBRASKA
GAME PARKS

NEW LIFE FOR AGING WATERS
AQUATIC HABITAT FUND
Celebrating 20 Years

SPORT FISH RESTORATION

NEBRASKA
Good Life. Great Resources.
DEPT. OF ENVIRONMENT AND ENERGY

The Nebraska Environmental Trust
"preserving NATURAL NEBRASKA" for future generations

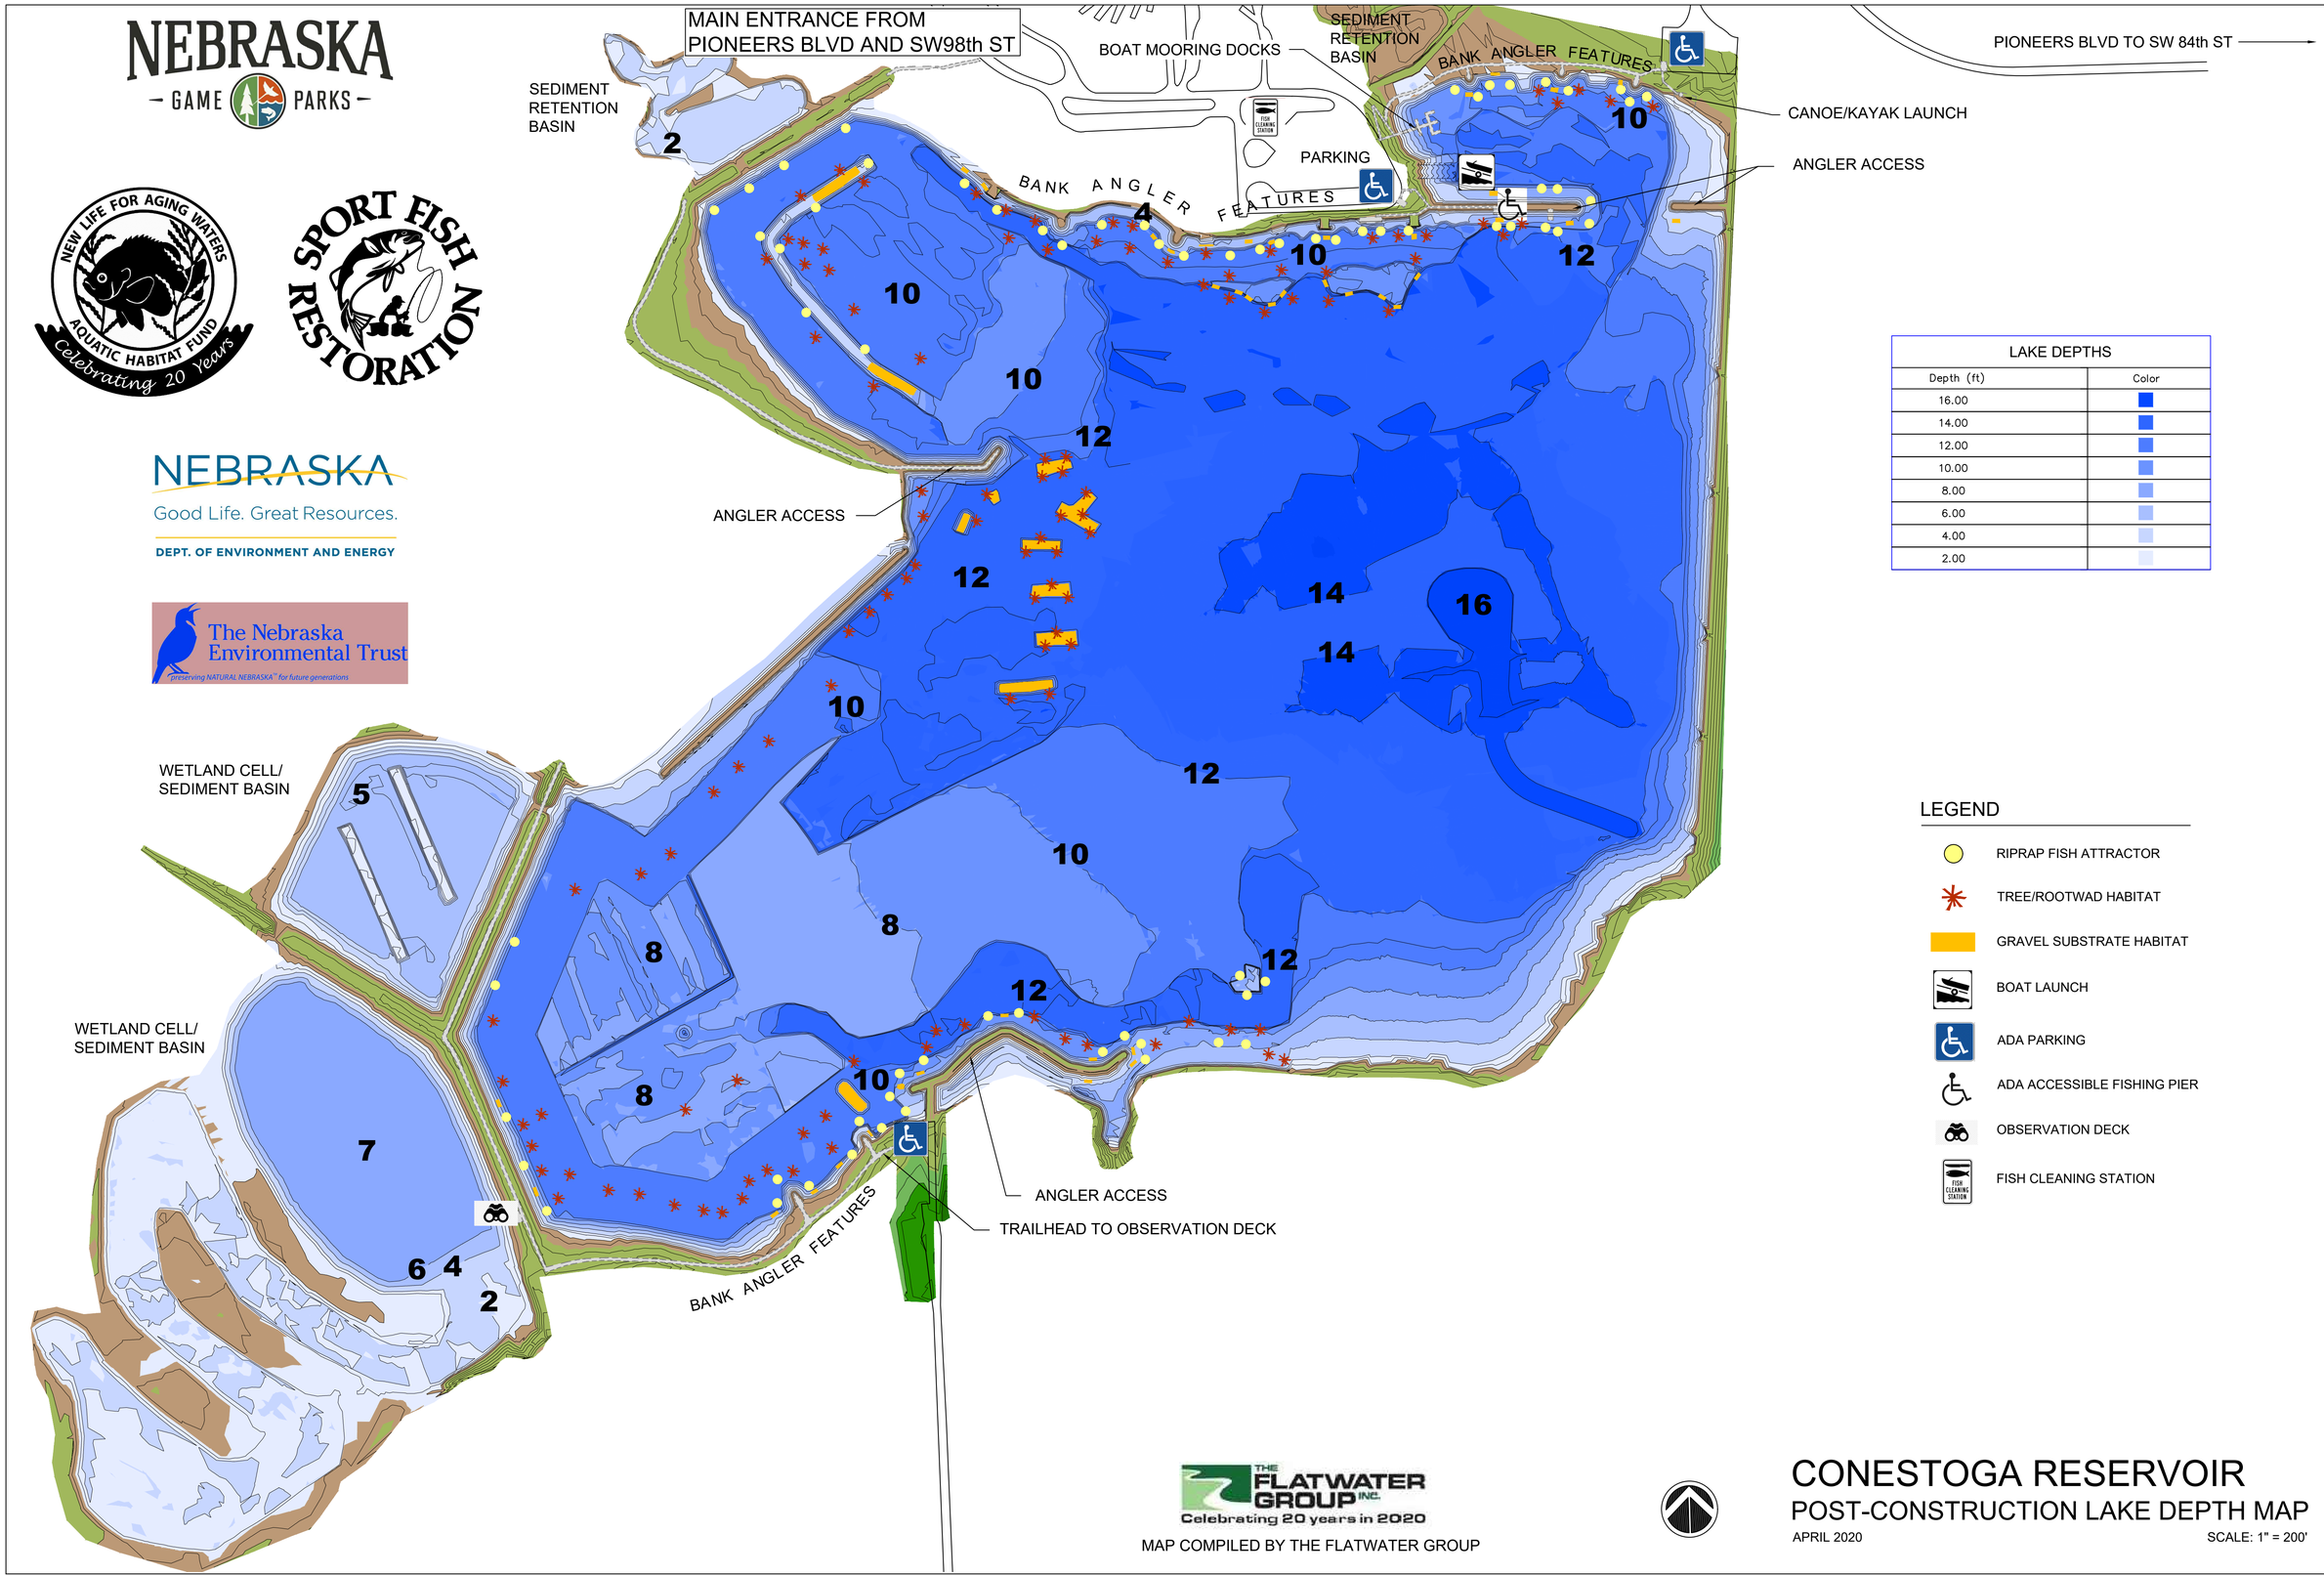

LAKE DEPTHS	
Depth (ft)	Color
16.00	
14.00	
12.00	
10.00	
8.00	
6.00	
4.00	
2.00	

LEGEND

- RIPRAP FISH ATTRACTOR
- TREE/ROOTWAD HABITAT
- GRAVEL SUBSTRATE HABITAT
- BOAT LAUNCH
- ADA PARKING
- ADA ACCESSIBLE FISHING PIER
- OBSERVATION DECK
- FISH CLEANING STATION

THE FLATWATER GROUP INC.
Celebrating 20 years in 2020

MAP COMPILED BY THE FLATWATER GROUP

CONESTOGA RESERVOIR

POST-CONSTRUCTION LAKE DEPTH MAP

APRIL 2020

SCALE: 1" = 200'